


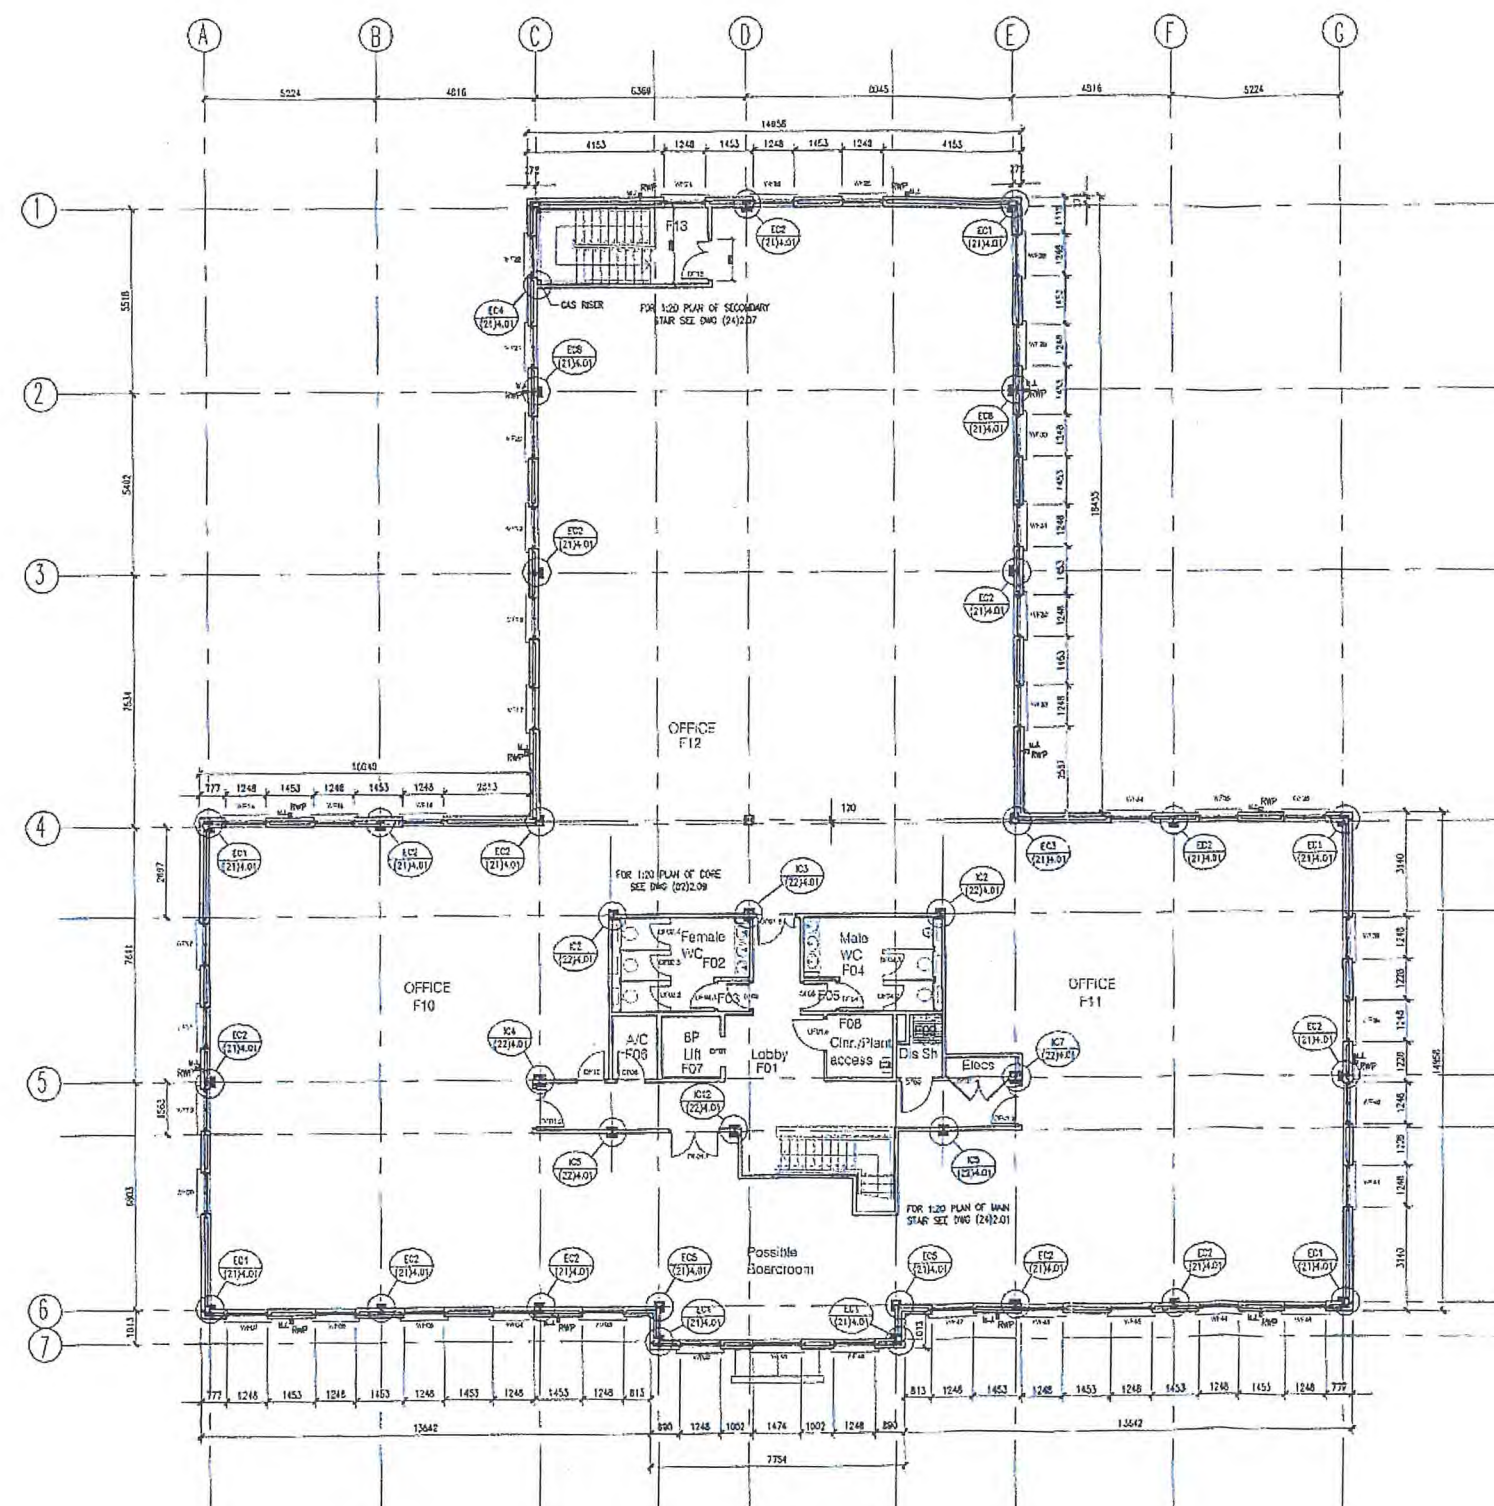

NOTES

This drawing is complete and shall be used for construction and shall not be used for any other purpose without the prior permission of the architect.

Do not scale from this drawing.

Dimensions are to be used in connection with all relevant materials, specifications, standards, and specifications.

Any dimensions in drawings or on site shall be taken from the drawings and shall be used for construction.

All dimensions are in millimetres unless otherwise stated.

Any survey information incorporated in this drawing cannot be deemed as accurate unless confirmed by third party.

(02)2.02 E

E	17.06.01	Final building	DS	01
C	03.08.01	1st issued	US	01
G	26.09.01	2nd issued	US	01
A	26.10.01	Revised from 17.06.01 and issued for Construction	DS	01

AS BUILT

B³	CLIENT	Longwood Developments
	PROJECT	Connaught House Ripley, Guildford
	FLOOR	Block 2 First Floor Plan
	DATE	1:100 @ A3 G7-01-00 6359-4
DRAWN BY		DS
CHECKED BY		(02)2.02 E
W		www.b3.co.uk